
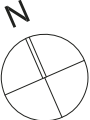
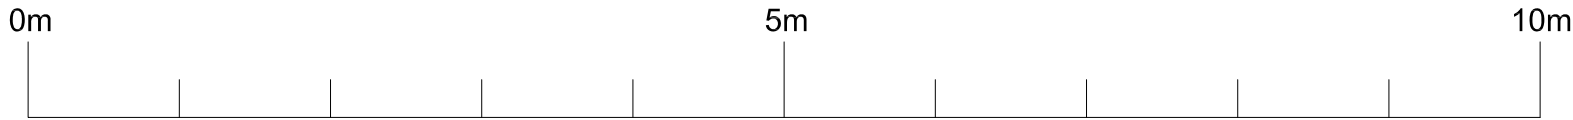


Gross External Area  
14.10 m2


Gross Internal Area  
12.43 m2

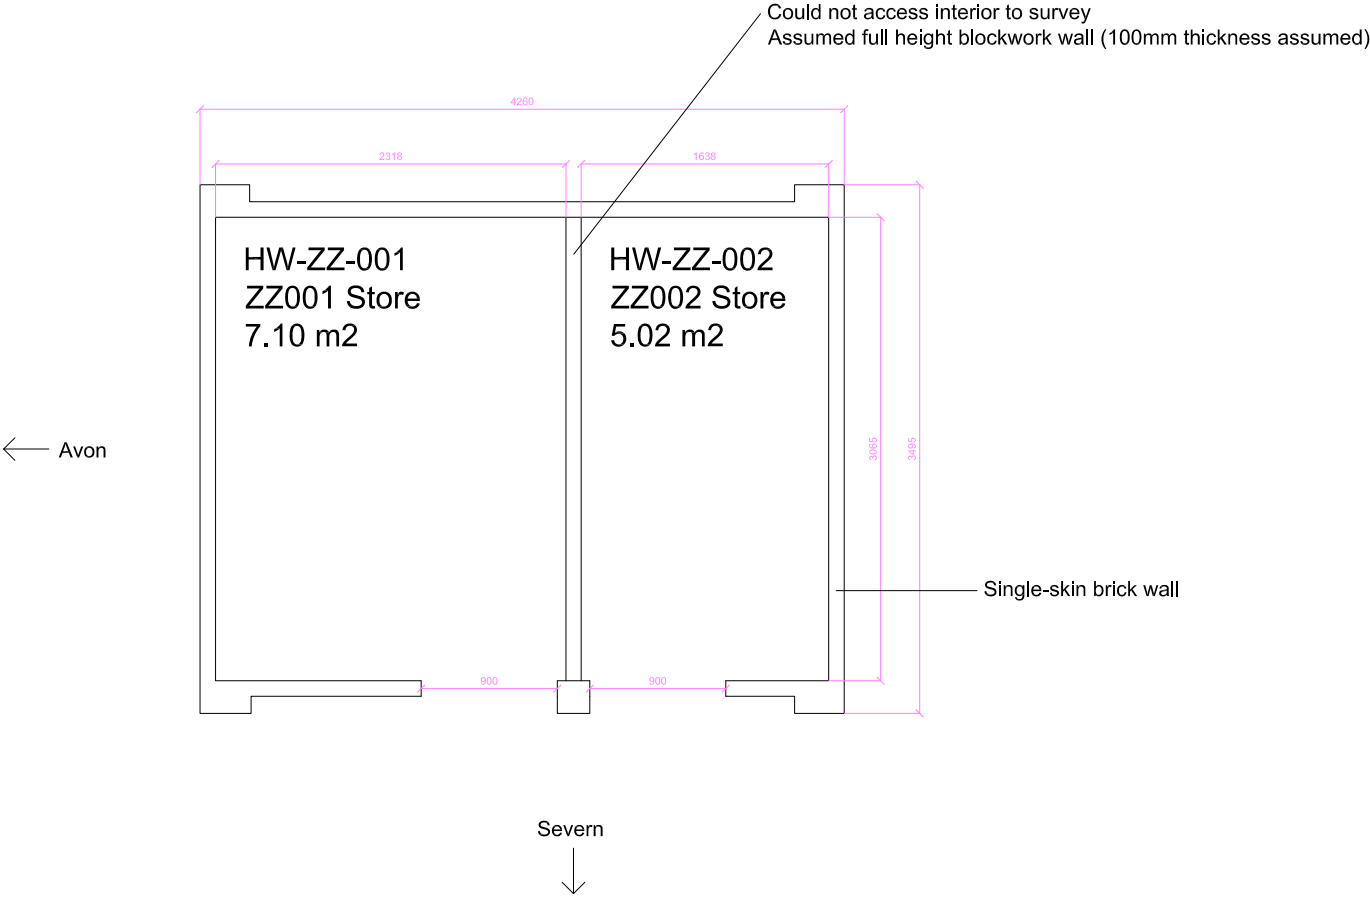

3rd Angle Projection U.N.O.

Do not scale this print.

Notes

Rev	Comment	By	Date
<div><b>UNIVERSITY OF GLOUCESTERSHIRE</b></div> <div>Estates Department Dunholme Villa Park Campus Cheltenham GL50 2RH t: 01242 714 888</div>			
Drawing Status <b>As Built</b>			
Campus Location <b>Hardwick Cheltenham GL50 4BS</b>			
Drawing Title <b>Store by Avon Ground Floor Floor Plan</b>			
Scale <b>1:50 @ A3</b>	Drawn <b>SLRWXX</b>	Check <b>XX</b>	Rev. <b>00</b>
Date <b>03-08-2021</b>			
Drawing Number <b>HW-ZZ-0-FP</b>			